


# GVEC Infrastructure

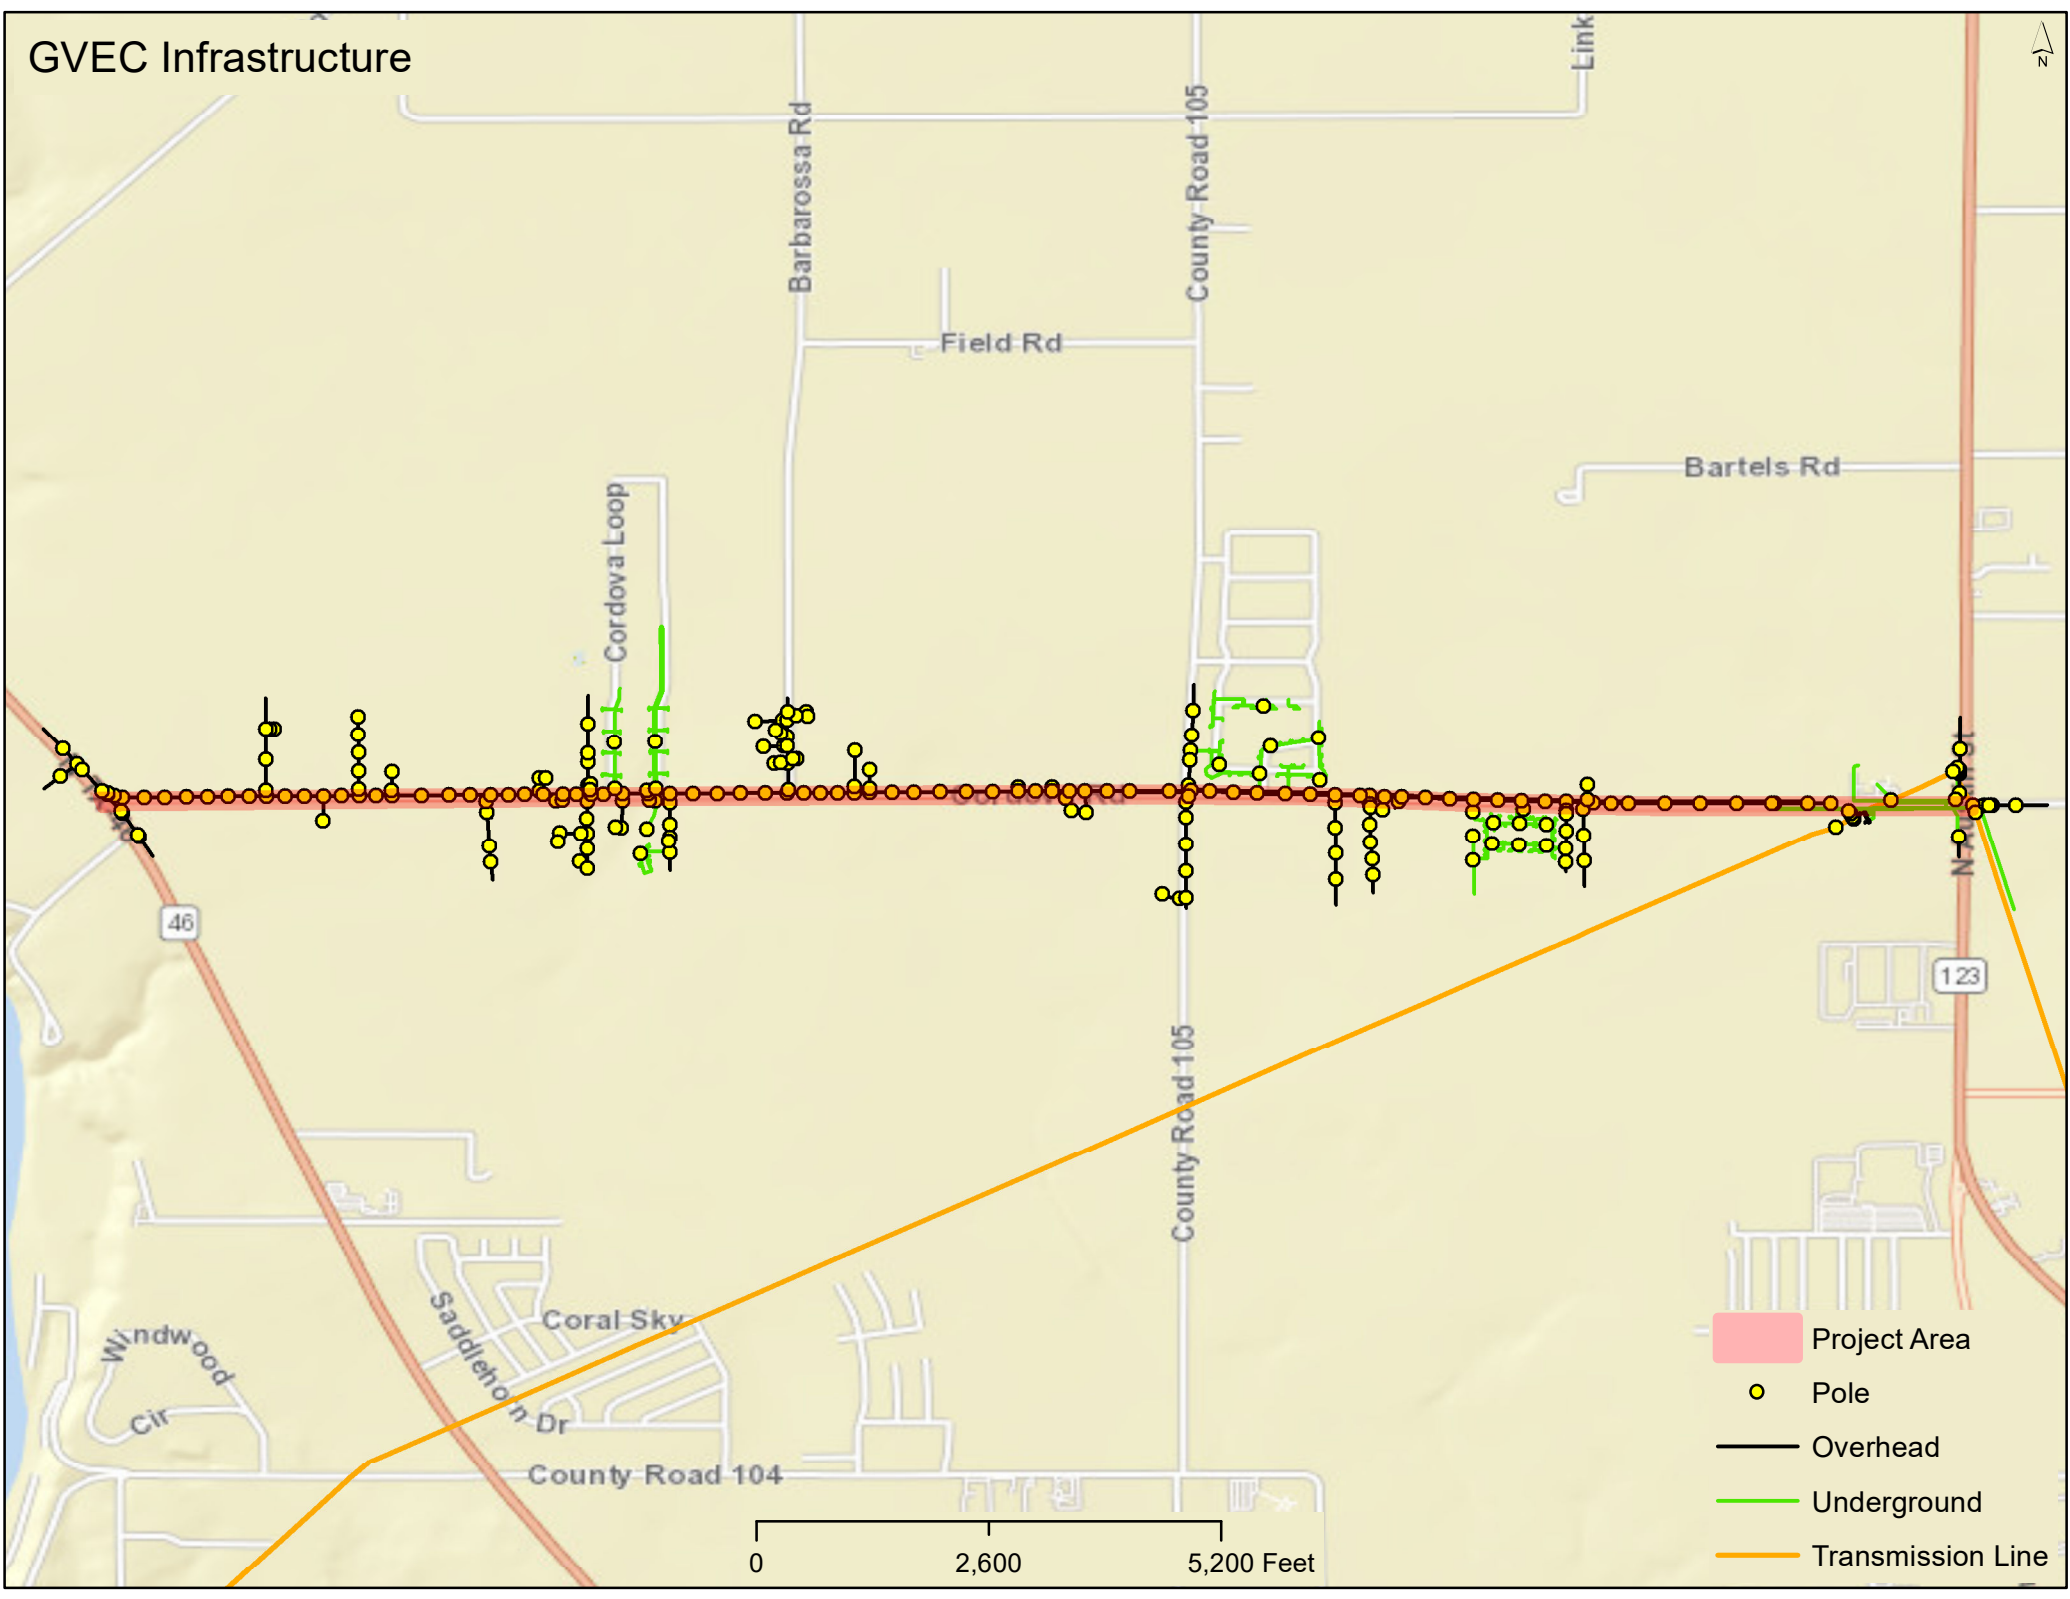

- Project Area
- Pole
- Overhead
- Underground
- Transmission Line

0 2,600 5,200 Feet